


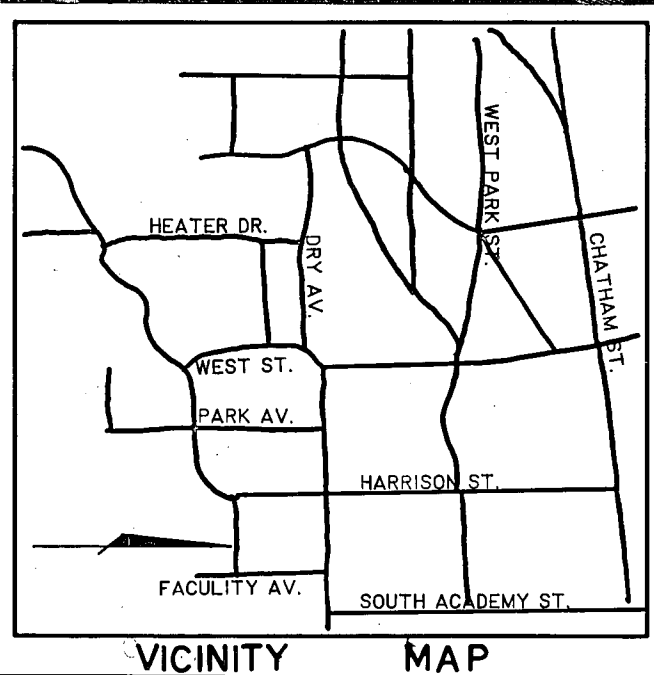


I, JEFF ARMSTRONG, CERTIFY THAT THIS MAP WAS DRAWN UNDER MY SUPERVISION FROM AN ACTUAL SURVEY MADE UNDER MY SUPERVISION AND BEING RECORDED IN THE WAKE COUNTY REGISTER OF DEEDS BOOK 898 PAGE 626

THE RATIO OF PRECISION AS CALCULATED BY LATITUDES AND DEPARTURES IS 1:N/A
ALL BOUNDARIES NOT SURVEYED ARE SHOWN AS BROKEN LINES. THIS MAP WAS PREPARED IN ACCORDANCE WITH G.S. 47-30 AS AMENDED.

WITNESS MY HAND AND SEAL THIS 19th DAY OF November, 1984


Jeff Armstrong
L-2576

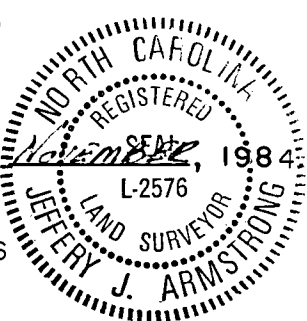

I, ROSEMARY GRAY, NOTARY PUBLIC IN AND FOR THE COUNTY OF WAKE AND STATE OF NORTH CAROLINA, DO HEREBY CERTIFY JEFF ARMSTRONG, APPEARED BEFORE ME THIS DAY AND ACKNOWLEDGED THE DUE EXECUTION OF THE FOREGOING CERTIFICATE AND WITNESS MY HAND AND NOTORIAL SEAL THIS THE 19th DAY OF November, 1984


MY COMMISSION EXPIRES 9-21-87

Rosemary Gray
NOTARY PUBLIC

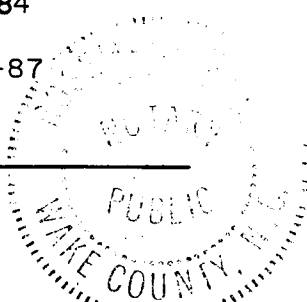


NOTE: THERE HAS BEEN NO BOUNDARY SURVEY DONE BY THIS OFFICE AT THIS TIME. BOUNDARY INFORMATION WAS TAKEN FROM A MAP PREPARED BY RUNA A. COOPER, CARY, N.C. DATED 2-21-84.

AS-BUILT
FOUNDATION LOCATIONS FOR
WESTPARK CONDOMINIUMS
TOWN OF CARY, NORTH CAROLINA

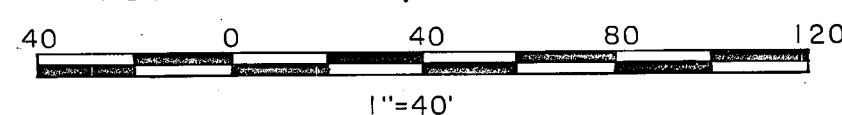

WEST STREET

50'

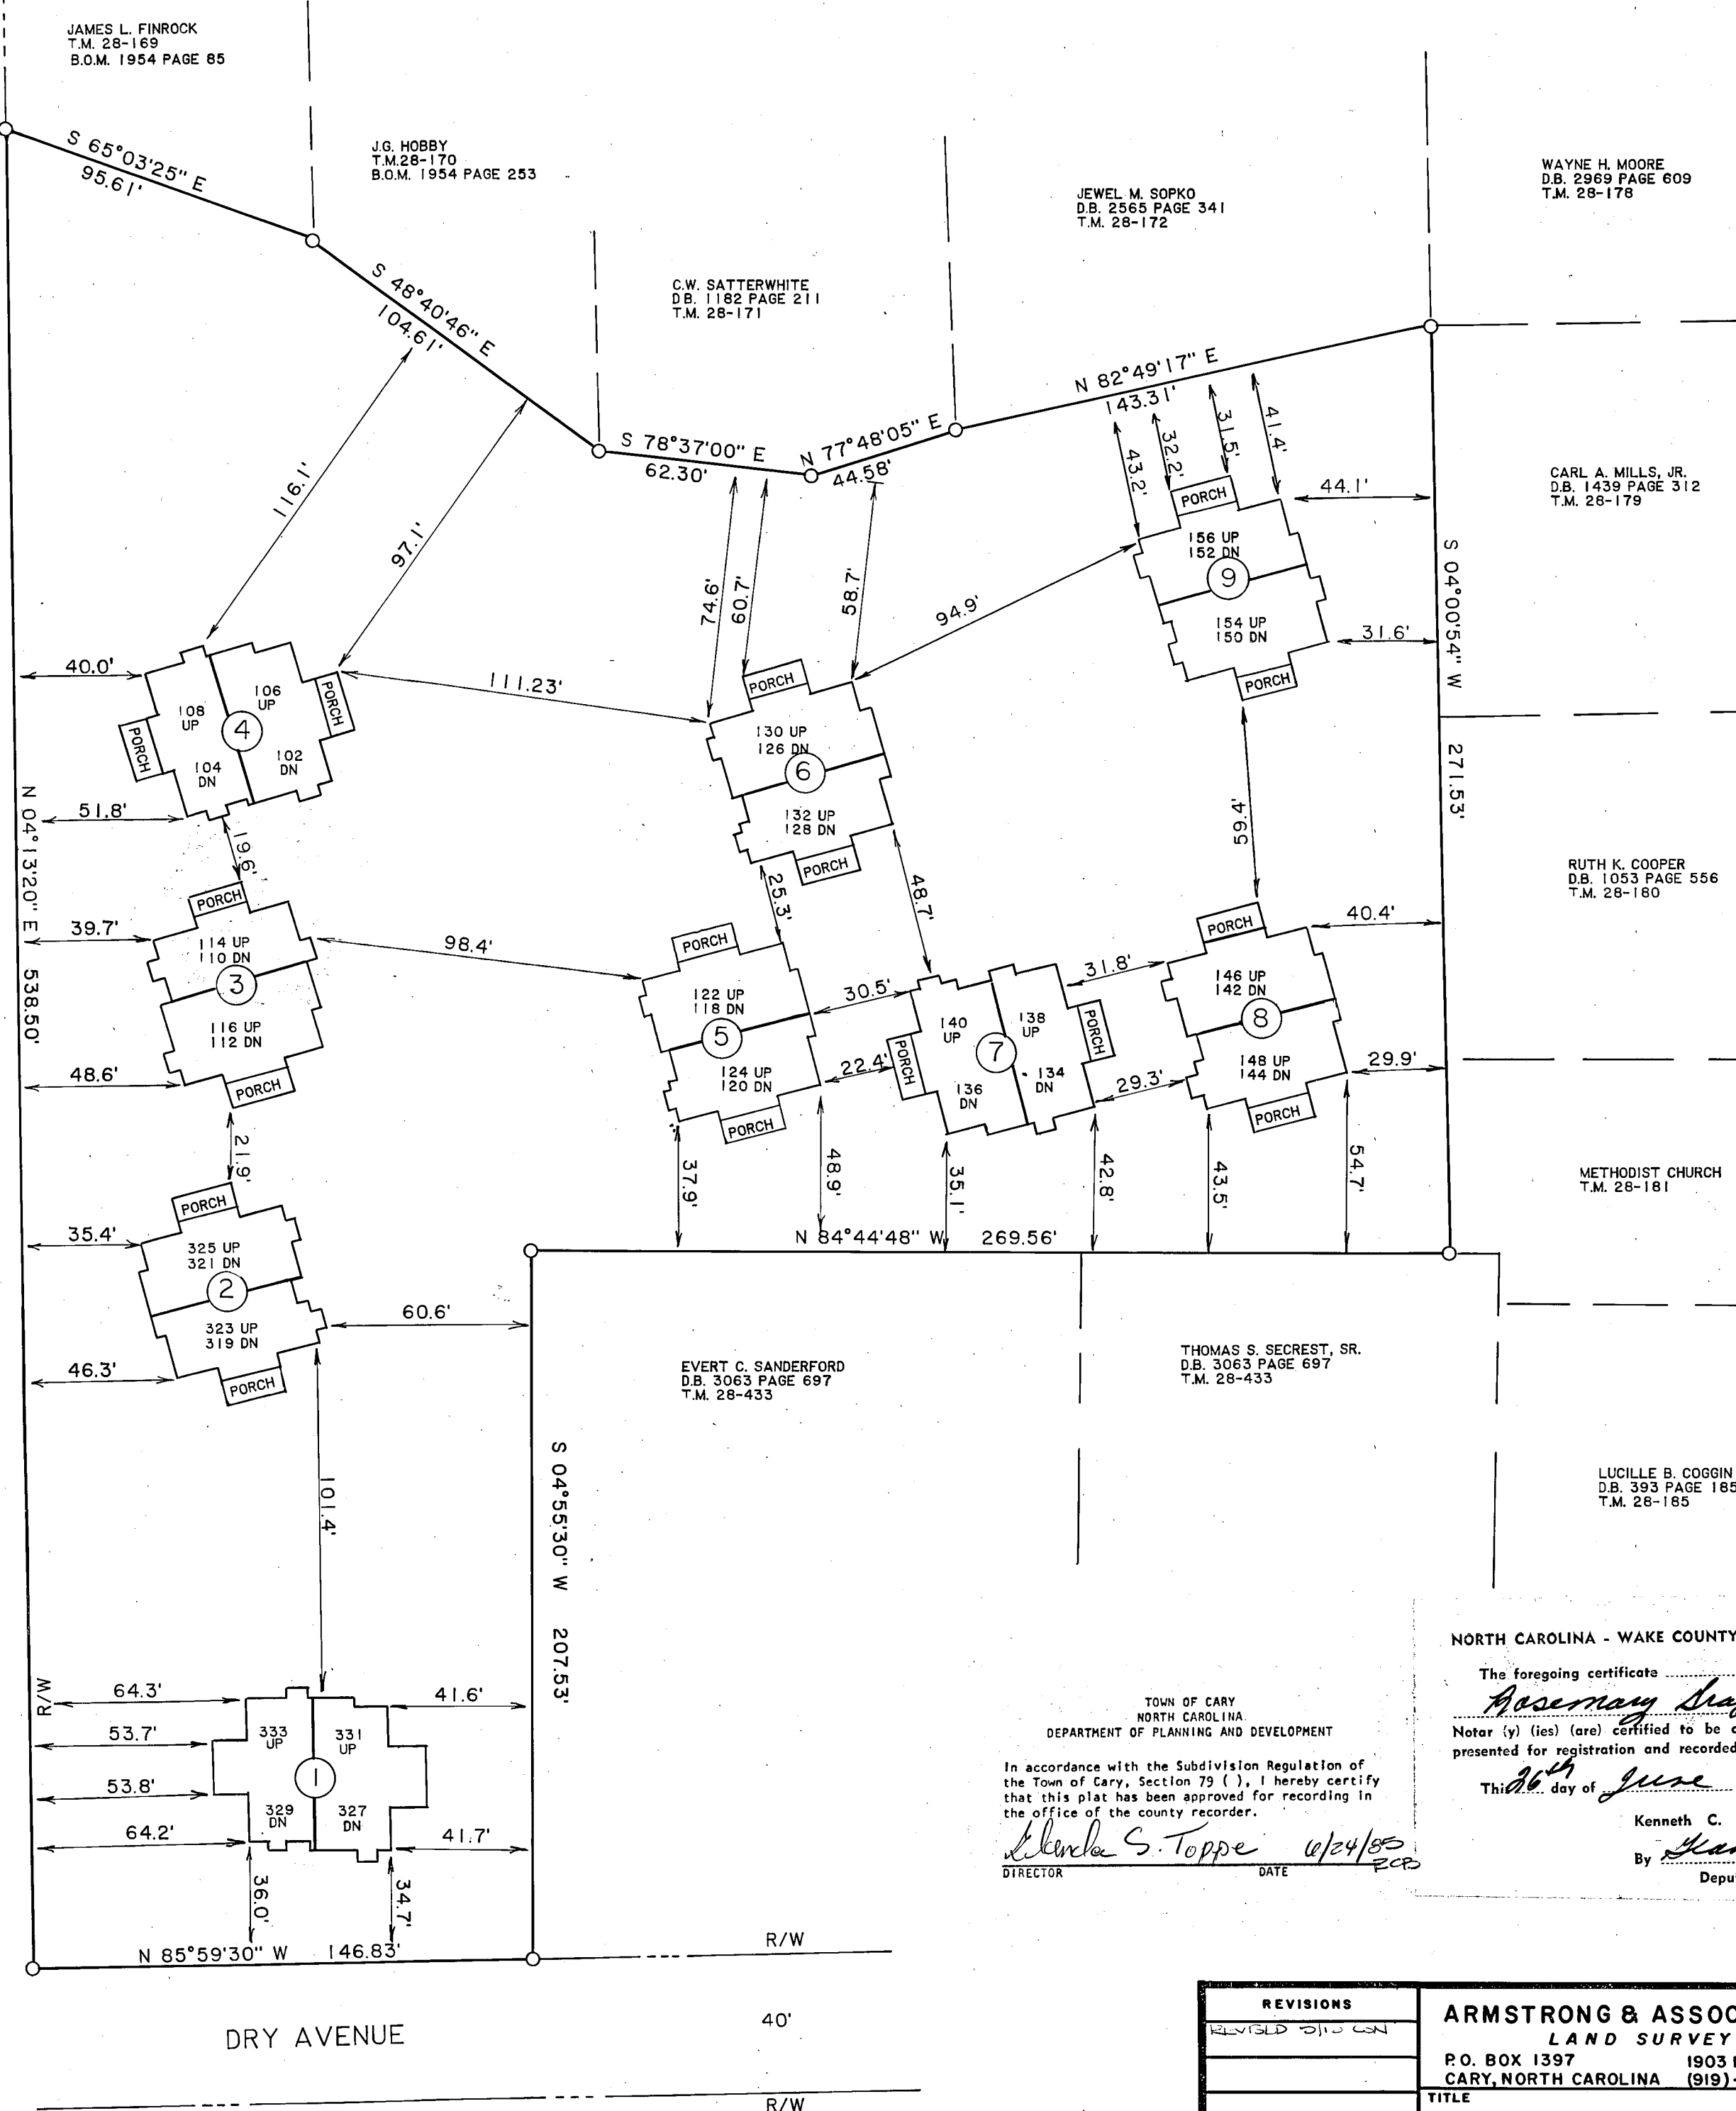

TOWN OF CARY
NORTH CAROLINA
DEPARTMENT OF PLANNING AND DEVELOPMENT
In accordance with the Subdivision Regulation of the Town of Cary, Section 79 (1), I hereby certify that this plat has been approved for recording in the office of the county recorder.
Shirley S. Toppe 6/24/85
DIRECTOR DATE

NORTH CAROLINA - WAKE COUNTY
The foregoing certificate of *Rosemary Gray*
Notary (y) (ies) (are) certified to be correct. This instrument was presented for registration and recorded in this office.
This day of June, 1985, at 4:25 o'clock P.
Kenneth C. Wilkins, Register of Deeds
By *Shirley S. Toppe*
Deputy Register of Deeds

REVISIONS			
REVISED	DATE	BY	REASON
ARMSTRONG & ASSOCIATES, INC. LAND SURVEYORS P.O. BOX 1397 1903 N. HARRISON AVE. CARY, NORTH CAROLINA (919) 469-8065			
TITLE WESTPARK CONDOMINIUMS			
SCALE 1"=40'	DR. BY JJA	DRAWING NO.	
DATE 11-19-84	CK'D. BY WRM	8482.0	